


PLAN VIEW
SCALE : 3/4" = 1'-0"

cushion to meet conrad standards
for upholstered chairs

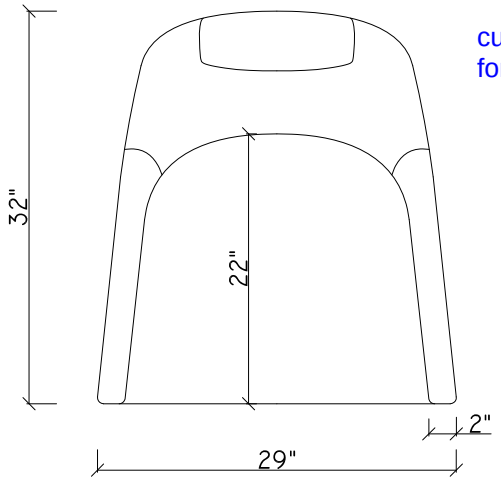

PERSPECTIVE VIEW
NOT TO SCALE

FABRIC: MR-601-FA


KM FABRICS
TARA
COL. CHARCOAL

GENERAL NOTES:


- TIGHT BACK
- TIGHT SEAT

- METAL BASE FINISH:
POLISHED NICKEL
FINISH SAMPLE TO BE PROVIDED

PROVIDE SAMPLE FOR REVIEW PRIOR TO FABRICATION

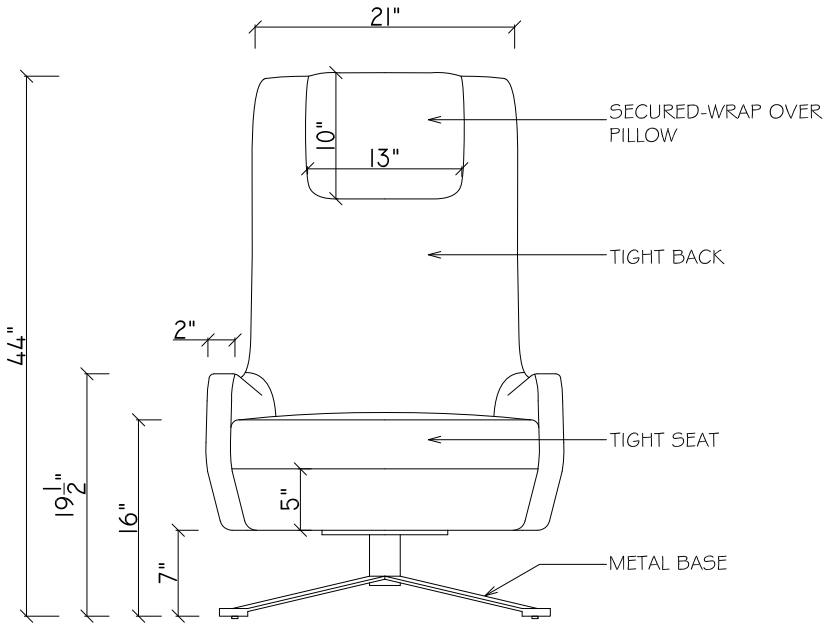

FRONT ELEV.
SCALE : 3/4" = 1'-0"

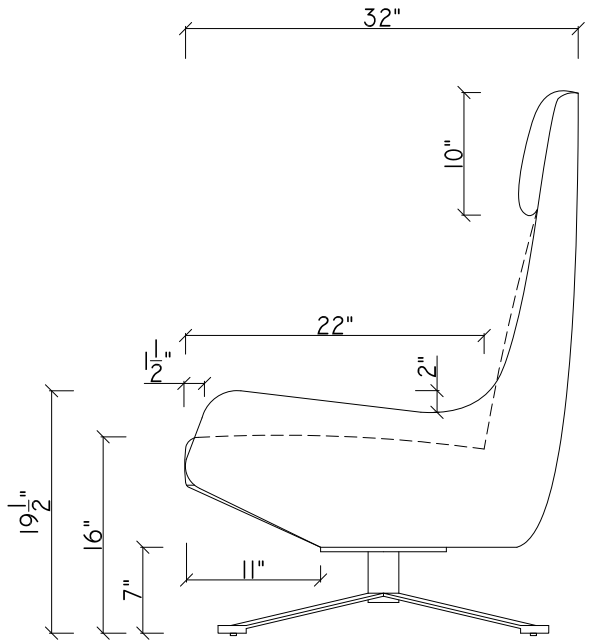

SIDE ELEV.
SCALE : 3/4" = 1'-0"

ACTION

SP
Signed

Cosigned

- ☐ A – No Exception Taken
- ☑ B – Proceed as Noted
- ☐ C – Revise and Resubmit
- ☐ D – Rejected
- ☐ E – For Information Only

This review is for the limited purpose of checking for general conformance with information given and the design concept expressed in the Interior Design Documents. The contractor shall be responsible for confirming and coordinating the accuracy and completeness of dimensions and quantities, for substantiating instructions for information or performance of equipment or systems, as well as all construction means, methods, techniques, sequences, and procedures. The Interior Designer's notes and comments on contractor's submittals do not relive the contractor from compliance with the Contract Documents.

	217031
Specification Section	*Project Number*
Submittal Number	*Previous Submittal*
01/23/2018	01/24/2018
Date Received	*Date Returned*

The Contractor shall review and comply with notes and comments on submittal in addition to notes provided on attached cover documents.

Rottet Studio

PAGE: 1

LOUIS INTERIORS
1283 Caledonia Road, M6A 2X7
Tel (416) 785-9909 Fax (416) 785-0301
info@louisinteriors.com


CUSTOMER: THE CARDY GROUP

TAG: CONRAD NY _ **MR-105-CH**

QTY: **1 PC**
LOUNGE CHAIR

PO #:	DATE DRAWN	REVISION #	AREA:
1111-0058	JAN 23 - 2018		MODEL ROOM

☐ APPROVED by:
☐ NOT APPROVED
☐ APPROVED W/ NOTES

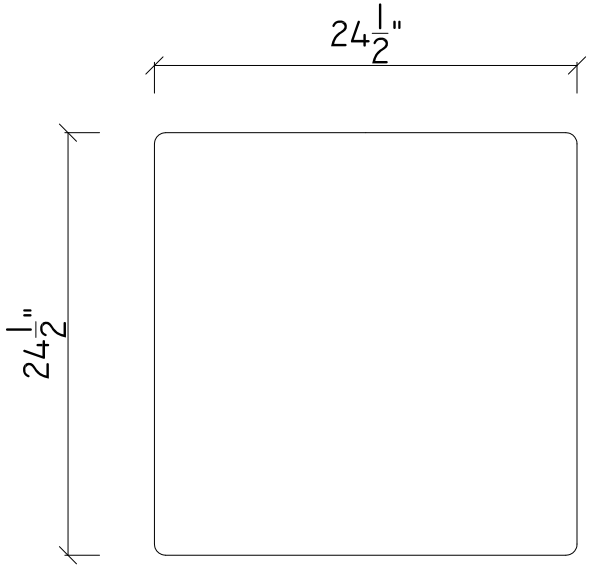

PLAN VIEW
SCALE : 1" = 1'-0"

ACTION

SP
Signed

Cosigned

- ☐ A – No Exception Taken
- ☑ B – Proceed as Noted
- ☐ C – Revise and Resubmit
- ☐ D – Rejected
- ☐ E – For Information Only

This review is for the limited purpose of checking for general conformance with information given and the design concept expressed in the Interior Design Documents. The contractor shall be responsible for confirming and coordinating the accuracy and completeness of dimensions and quantities, for substantiating instructions for information or performance of equipment or systems, as well as all construction means, methods, techniques, sequences, and procedures. The Interior Designer's notes and comments on contractor's submittals do not relive the contractor from compliance with the Contract Documents.

	217031
Specification Section	*Project Number*
Submittal Number	*Previous Submittal*
01/23/2018	01/24/2018
Date Received	*Date Returned*

The Contractor shall review and comply with notes and comments on submittal in addition to notes provided on attached cover documents.

Rottet Studio

FABRIC: MR-601-FA


KM FABRICS
TARA
COL. CHARCOAL

GENERAL NOTES:


- TIGHT SEAT

- METAL BASE FINISH:
POLISHED NICKEL
FINISH SAMPLE TO BE PROVIDED

PROVIDE SAMPLE FOR REVIEW PRIOR TO FABRICATION

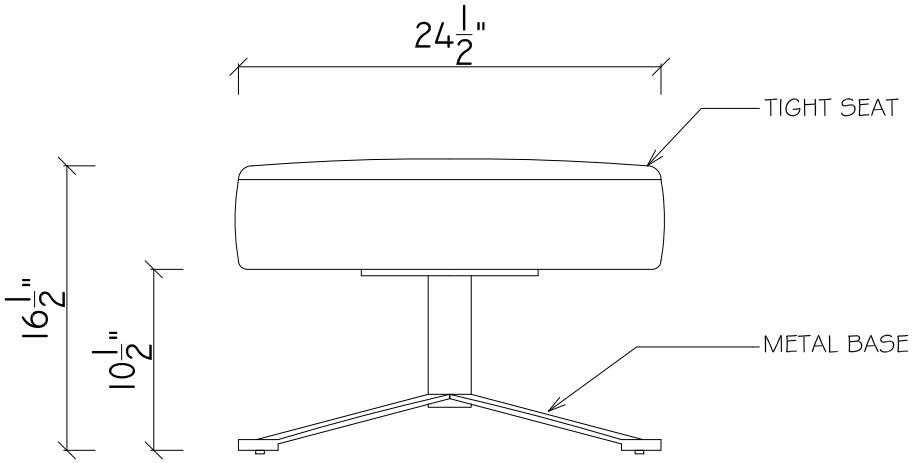

FRONT ELEV.
SCALE : 1" = 1'-0"

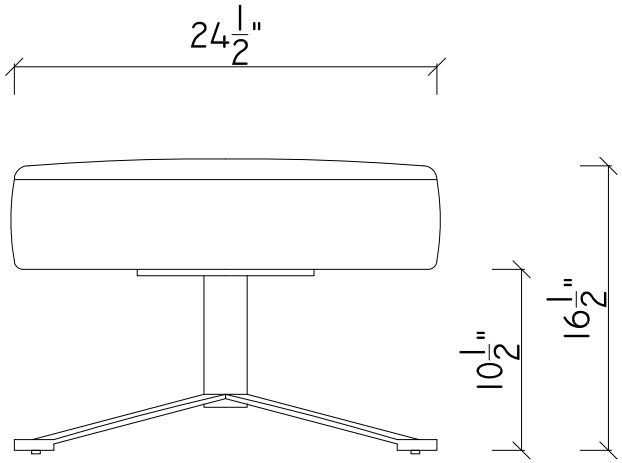

SIDE ELEV.
SCALE : 1" = 1'-0"

LOUIS INTERIORS
1283 Caledonia Road, M6A 2X7
Tel (416) 785-9909 Fax (416) 785-0301
info@louisinteriors.com

CUSTOMER: THE CARDY GROUP			QTY: 1 PC OTTOMAN
TAG: CONRAD NY _ **MR-105-CH**			
PO #: 1111-0058	DATE DRAWN: JAN 23 - 2018	REVISION #	AREA: MODEL ROOM

PAGE: 2

☐ APPROVED by:
☐ NOT APPROVED
☐ APPROVED W/ NOTES